



Express Mail No.: EL988725032US
Title: METHOD OF COVERING A POTTED PLANT
Inventors: Donald E. Weder
Filed: Herewith
Agent: Christopher W. Corbett
SHEET 3 OF 22

Deposited: 08/20/2003
Group: 3644
Examiner: F. Palo
Dkt. No.: 8403.954
Redline Drawings HUKNINI KKVYIK 50

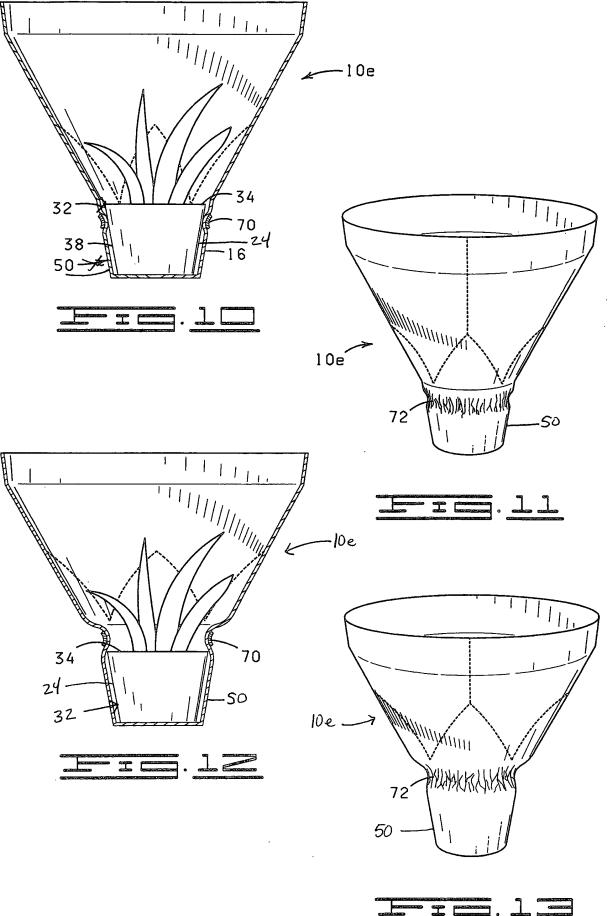

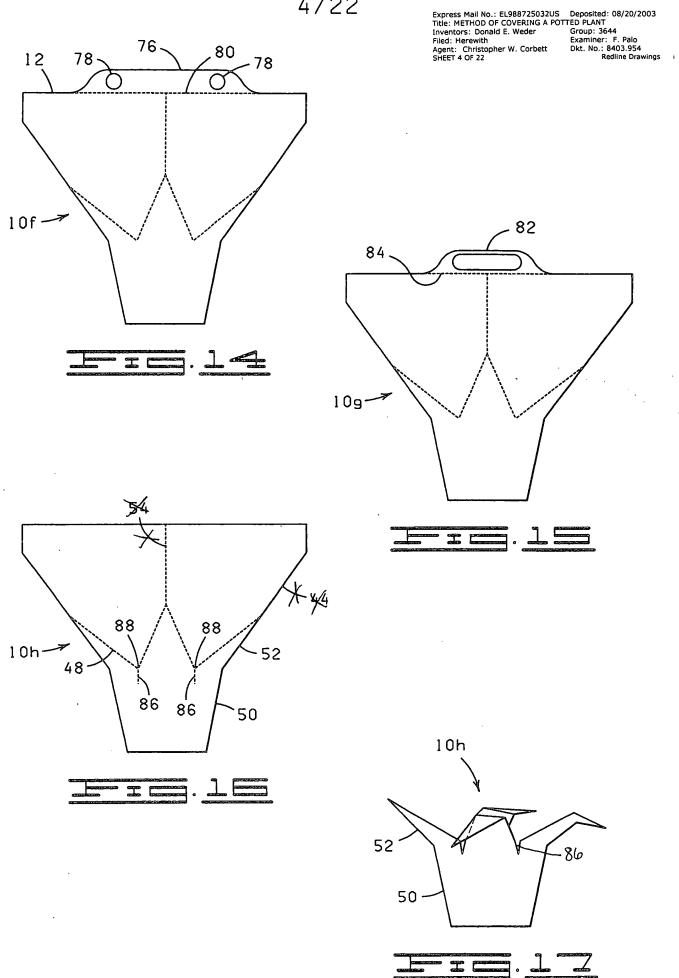



Express Mail No.: EL988725032US


Title: METHOD OF COVERING A POTTED PLANT
Inventors: Donald E. Weder
Filed: Herewith
Agent: Christopher W. Corbett
SHEET 5 OF 22


Deposited: 08/20/2003


Group: 3644
Examlner: F. Palo
Dkt. No.: 8403.954
Redline Drawings

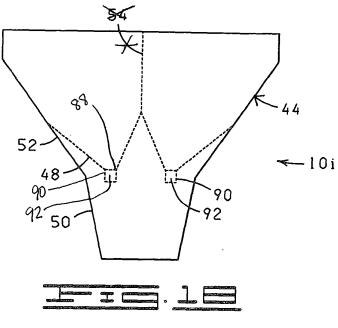


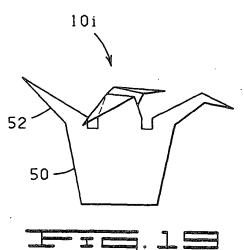


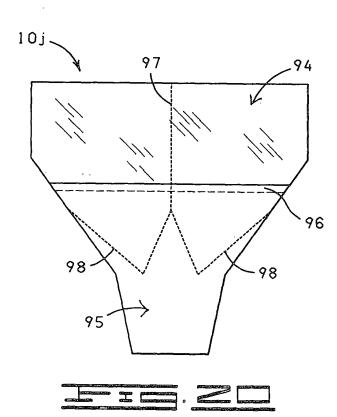


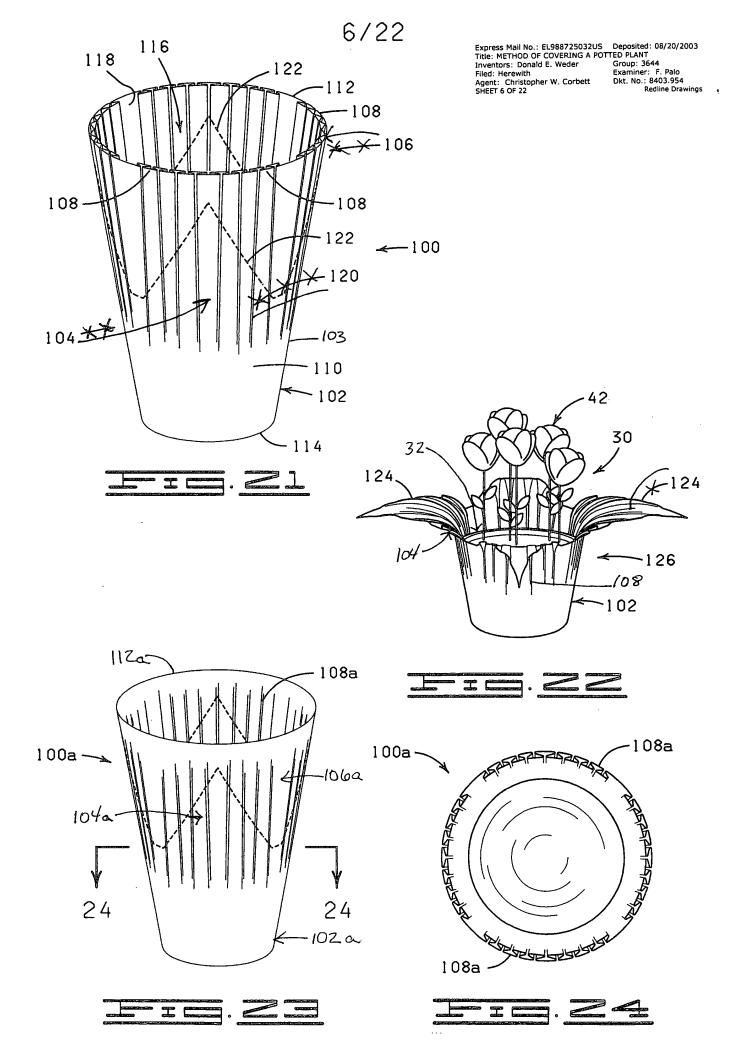

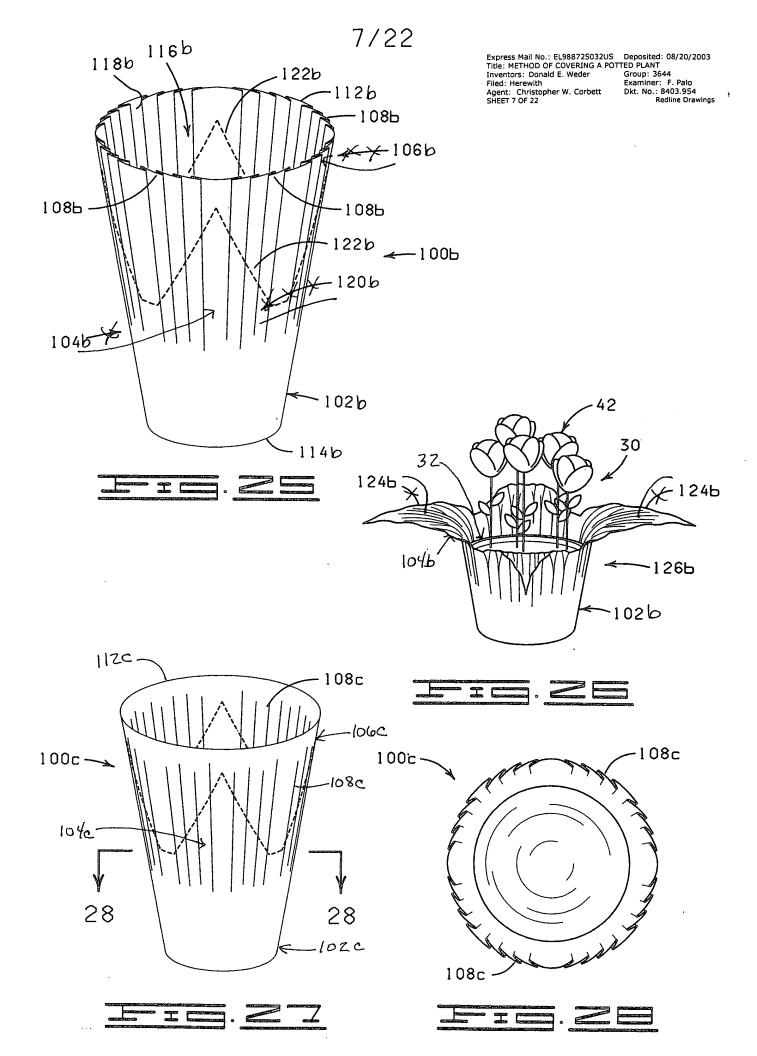

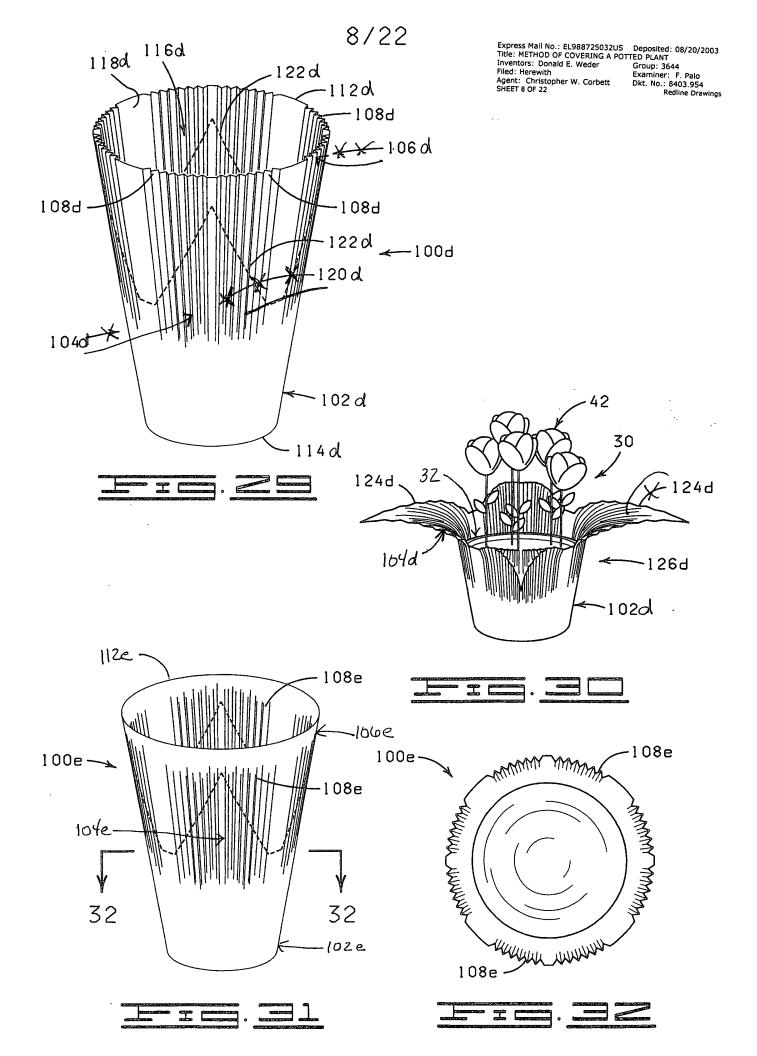


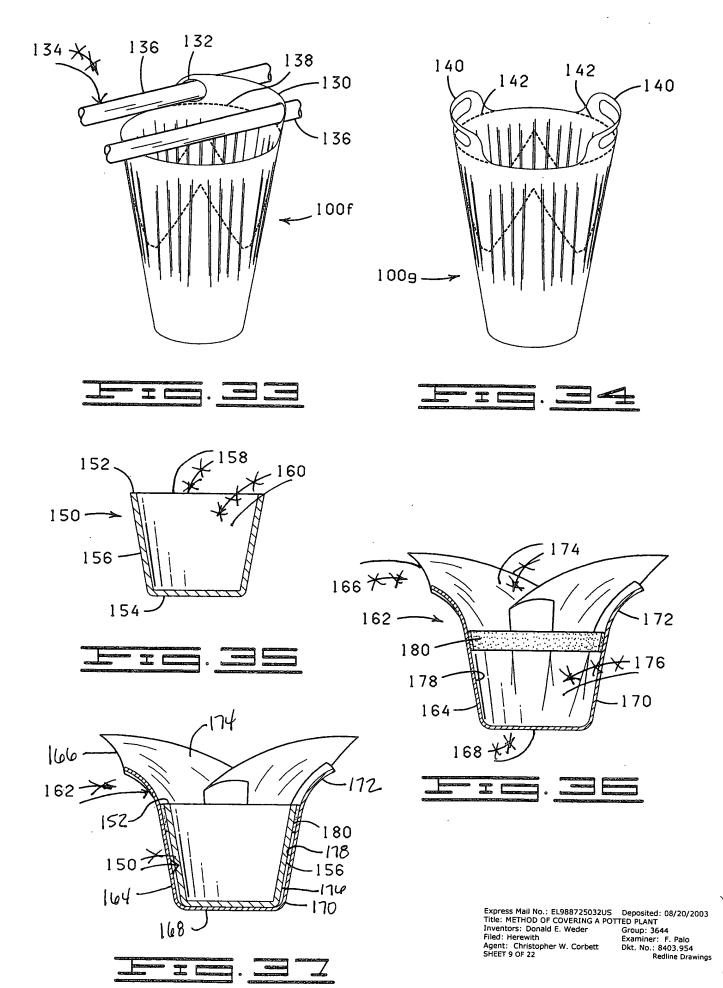

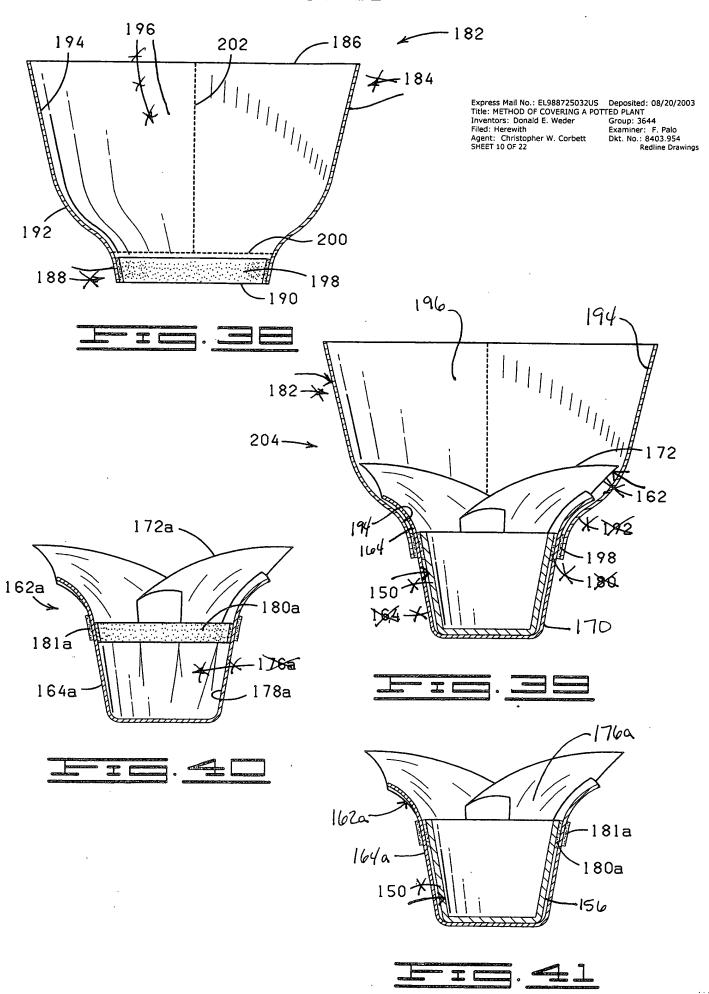


Express Mail No.: EL988725032US Deposited: 08/20/2003
Title: METHOD OF COVERING A POTTED PLANT
Inventors: Donald E. Weder
Filed: Herewith Agent: Christopher W. Corbett
SHEET 12 OF 22 Deposited: 08/20/2003
Group: 3644
Examiner: F. Palo
Dkt. No.: 8403.954
Redline Drawings

172b
162b
178b
164b
170b
178b
150a
162b

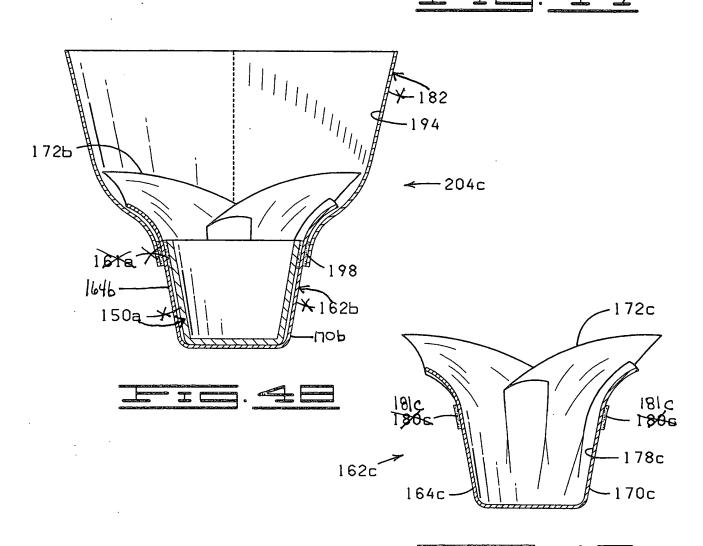

Express Mail No.: EL988725032US
Title: METHOD OF COVERING A POTTED PLANT
Inventors: Donald E. Weder
Filed: Herewith
Agent: Christopher W. Corbett
SHEET 14 OF 22

Deposited: 08/20/2003
Group: 3644
Examiner: F. Palo
Dkt. No.: 8403.954
Redline Drawings

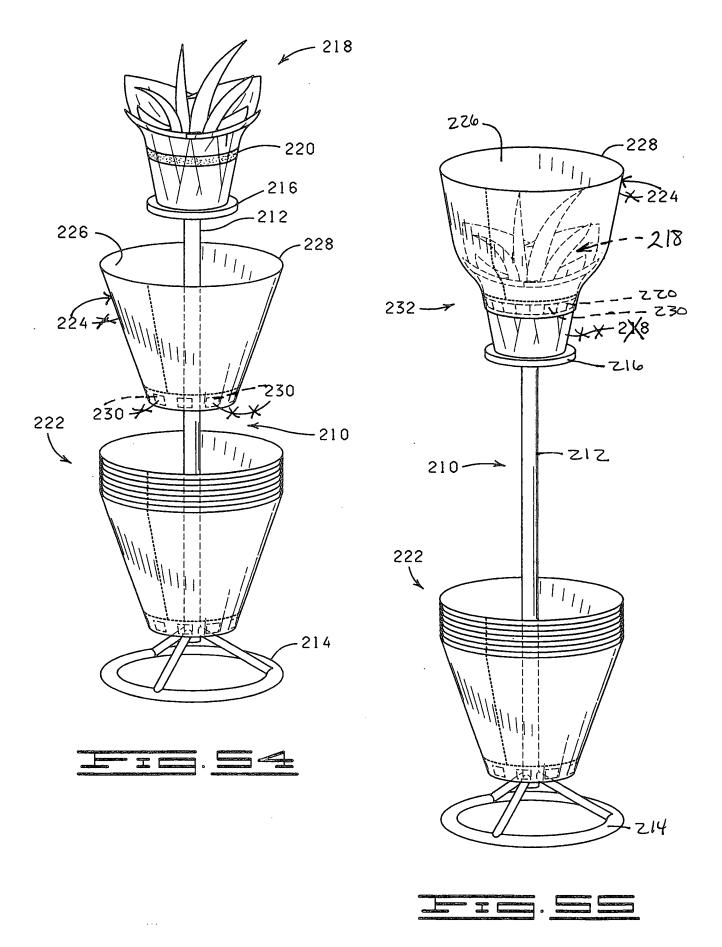



Express Mail No.: EL988725032US

Title: METHOD OF COVERING A POTTED PLANT
Inventors: Donald E. Weder
Filed: Herewith
Agent: Christopher W. Corbett
SHEET 15 OF 22

Deposited: 08/20/2003


Group: 3644
Examiner: F. Palo
Dkt. No.: 8403.954
Redline Drawings

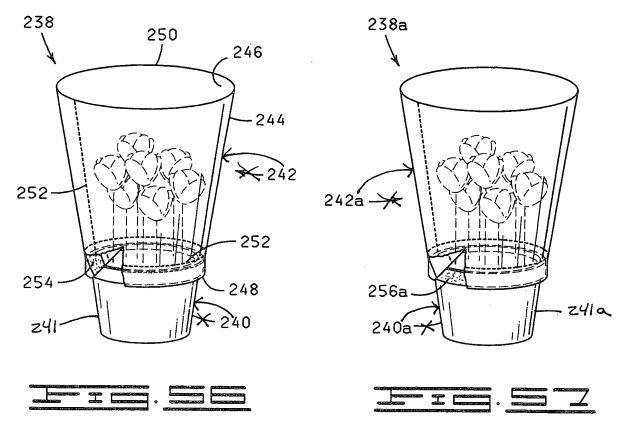


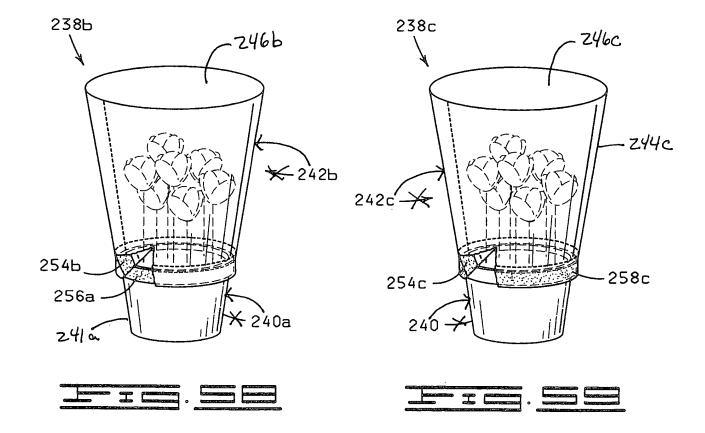



Express Mail No.: EL988725032US
Title: METHOD OF COVERING A POTTED PLANT
Inventors: Donald E. Weder
Filed: Herewith
Agent: Christopher W. Corbett
SHEET 16 OF 22

Deposited: 08/20/2003
Group: 3644
Examiner: F. Palo
Dkt. No.: 8403.954
Redline Drawings

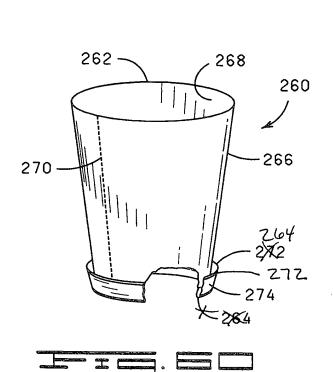


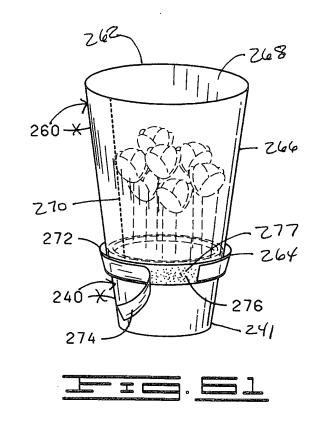


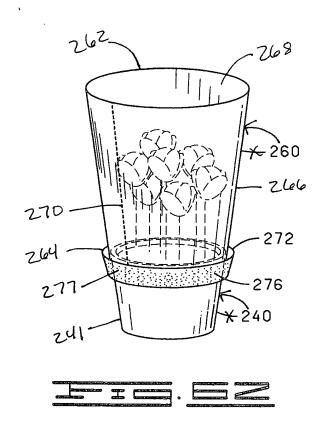

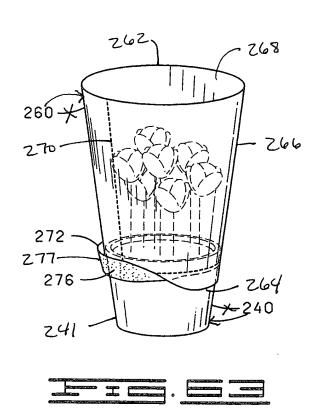


Express Mail No.: EL988725032US Deposited: 08/20/2003
Title: METHOD OF COVERING A POTTED PLANT
Inventors: Donald E. Weder Group: 3644
Filed: Herewith Examiner: F. Palo
Agent: Christopher W. Corbett SHEET 17 OF 22 Redline Drawings

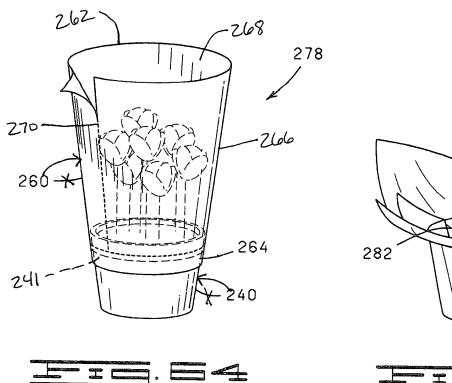

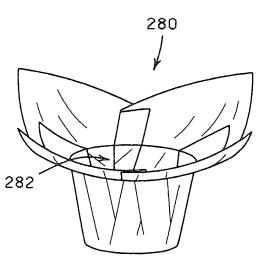





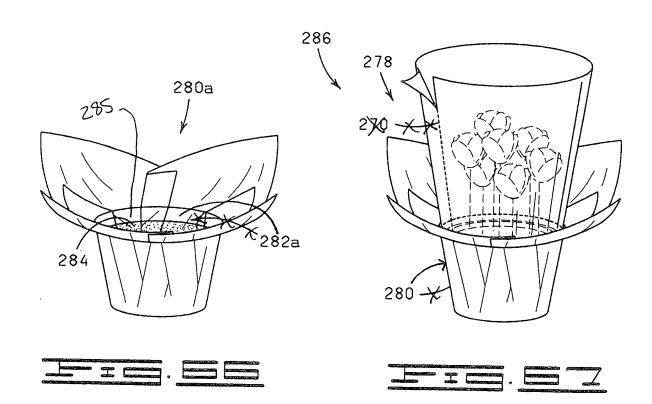


Express Mail No.: EL988725032US
Title: METHOD OF COVERING A POTTED PLANT
Inventors: Donald E. Weder
Filed: Herewith
Agent: Christopher W. Corbett
SHEET 18 0F 22

Deposited: 08/20/2003
Group: 3644
Examiner: F. Palo
Dkt. No.: 8403.954
Redline Drawings - 288 - 298 - 302 308--300 - 288 ×310 - 300 294-300 ×

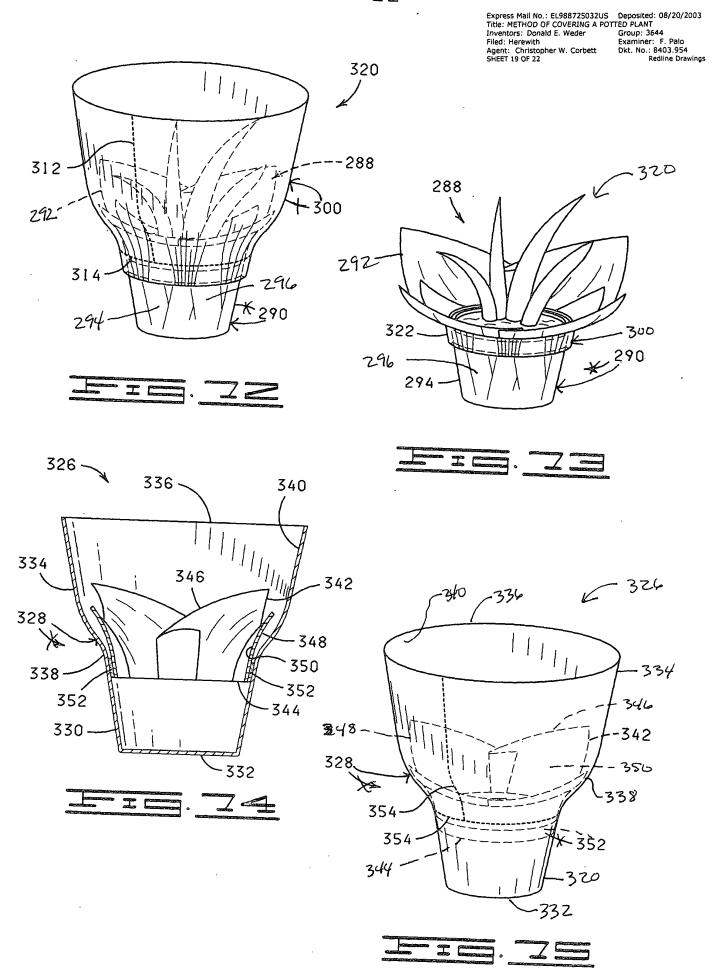

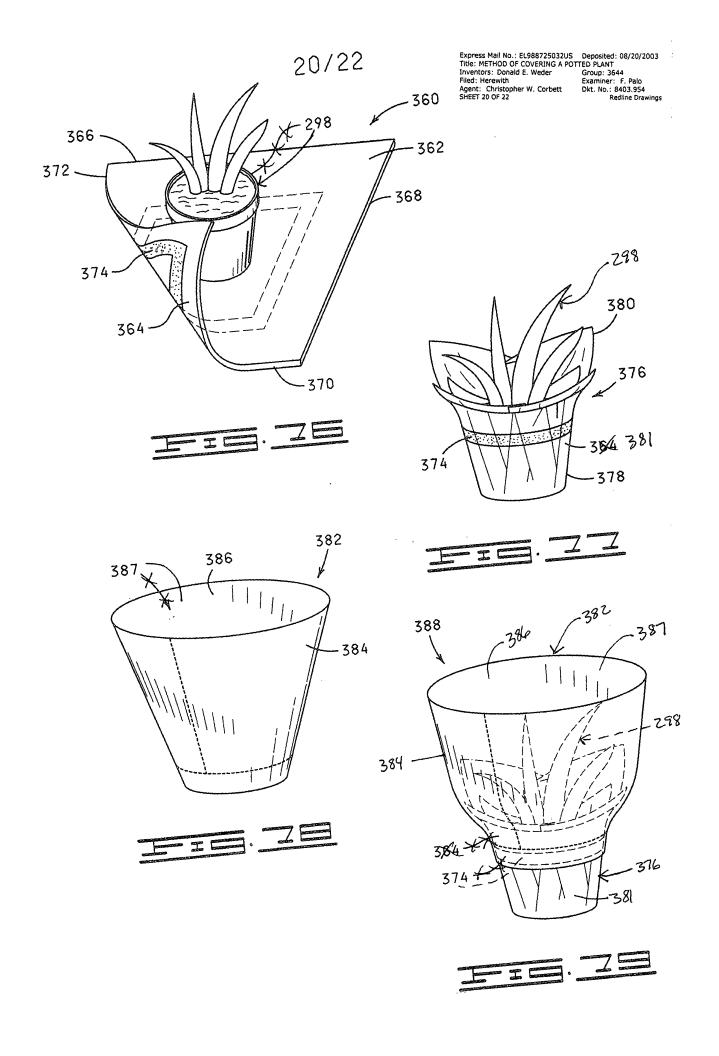

296

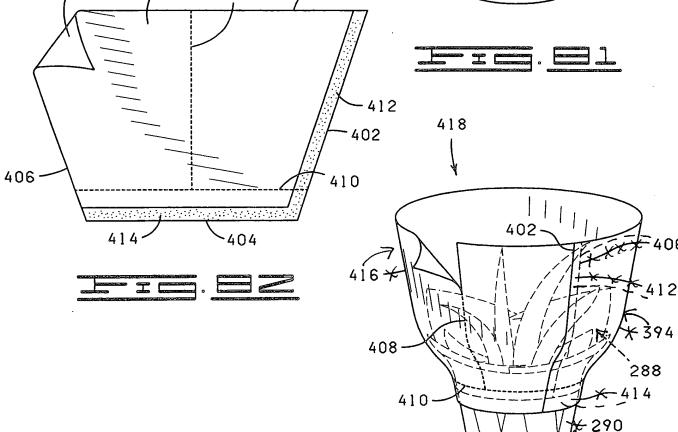

382a

390

396

408

398

394

386a

